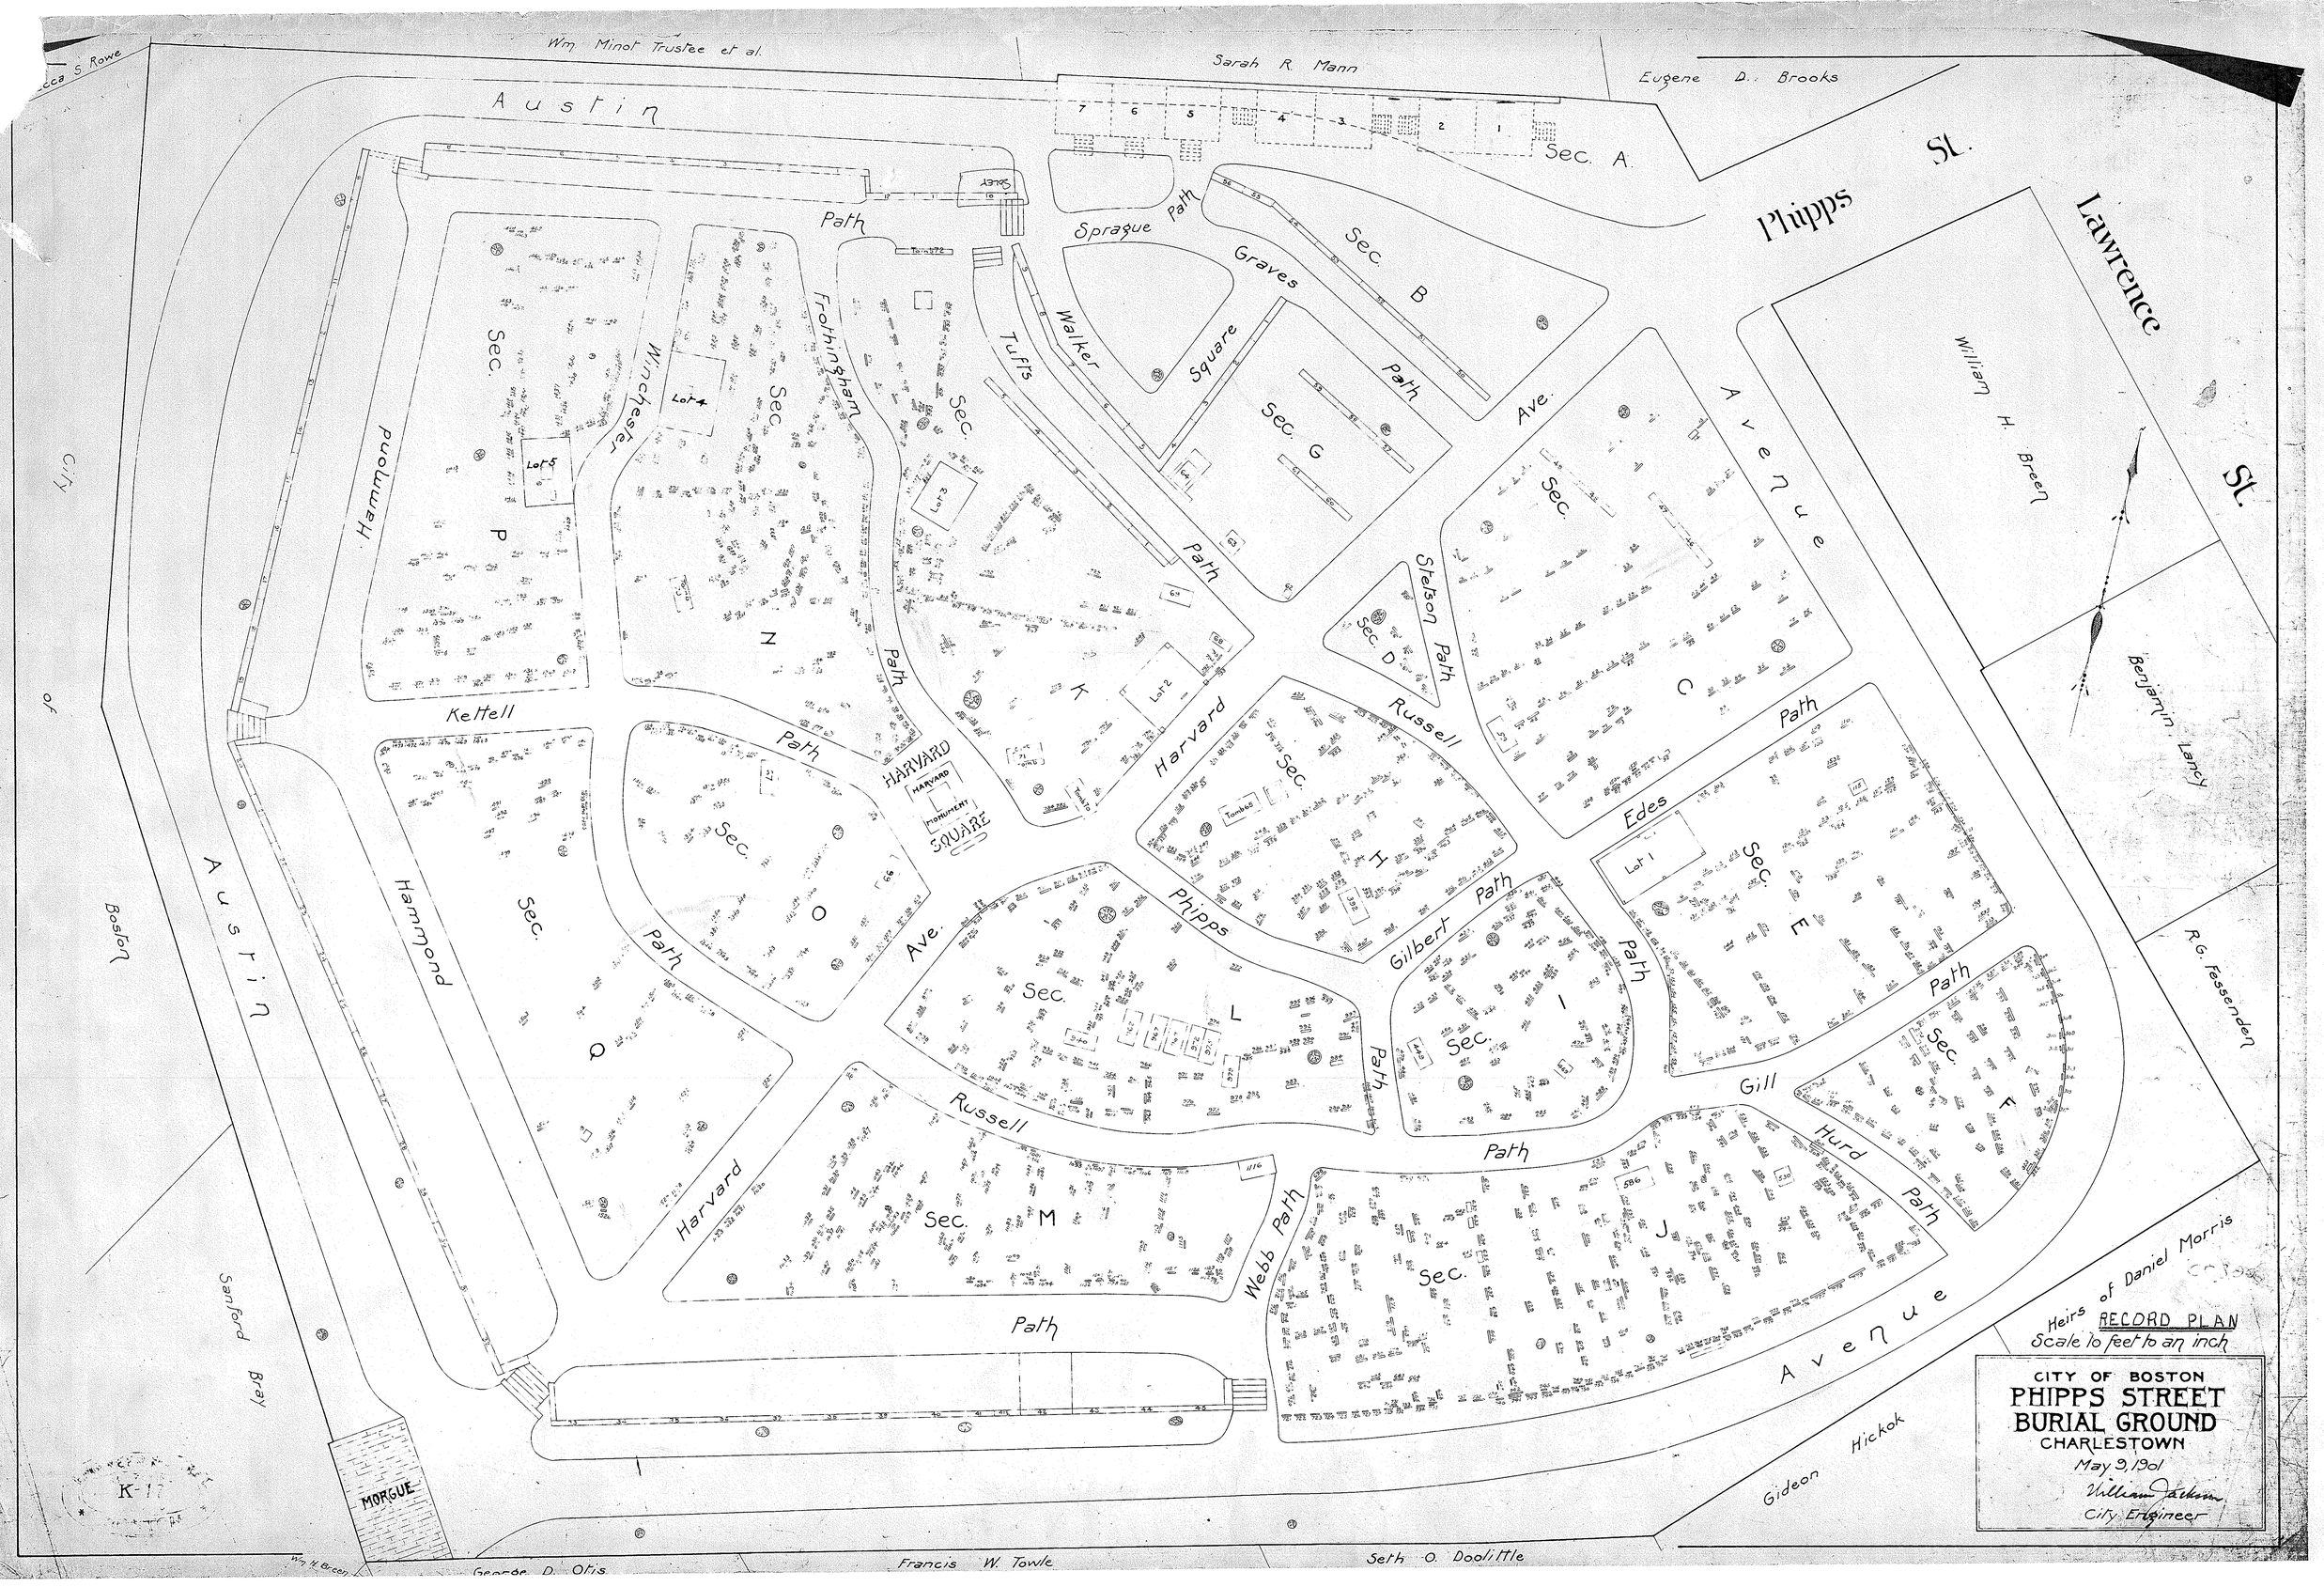

Wm. Minot Trustee et al.
Sarah R. Mann
Eugene D. Brooks
Austin
Sec. A.
Phipps St.
Lawrence St.
Sprague Path
Graves Path
Sec. B
Square
Sec. G
Walker
Tufts
Frothingham
Winchester
Hammond
Sec. P
Lot 5
Lot 4
Sec. N
Sec. K
Lot 3
Lot 2
Path
Ave.
Avenue
Sec. C
Stetson Path
Sec. D
Russell
Harvard
Sec. H
Edes Path
Lot 1
Sec. E
Gilbert Path
Sec. I
Sec. F
Gill
Hurd Path
Sec. J
Webb Path
Sec. M
Sec. L
Sec. O
Sec. Q
Kettell
HARVARD
HARVARD MONUMENT SQUARE
Phipps
Ave.
Hammond
Austin
Boston
City of
Sanford Bray
MORGUE
William H. Breen
Benjamin Lancy
R.G. Fessenden
Gideon Hickok
Heirs of Daniel Morris
RECORD PLAN
Scale 10 feet to an inch
CITY OF BOSTON
PHIPPS STREET
BURIAL GROUND
CHARLESTOWN
May 9, 1901
City Engineer
George D. Otis
Francis W. Towle
Seth O. Doolittle